

Work Order ID 55827

February 3, 2010 7:25:39 AM



Page 1

Item ID: D3443-7

Accept



Setup Start



Revision ID:

Item Name: Tubing

Stop



Start Date: 2/03/10

Start Qty: ~~6.00~~ 10 SB



Cust Item ID:

Required Date: 2/04/10

Req'd Qty: 6.00



Customer:

Reference:

Approvals:

Process Plan: W

Date:

Tooling:

Date:

Run Start



QC:

Date:

SPC (Y/N):

Date:

Stop



Sequence ID/
Work Center ID

Operation
Description

Set Up/
Run Hours

Draw
Number

Draw
Rev.

Plan
Code

Accept
Qty

Reject
Qty

Reject
Number

Insp.
Stamp

Draw Nbr

Revision Nbr

D3443

Rev C

100

0.00



NC BRAKE

Brake NC

Memo

0.00

Brake NC

1- Form as per Dwg D3443 using DT8117□2- Deburr per dwg D3443

→ SB 10/02/03

SAD 10-02-03

10

110

0.00



Small Fab

Small Fab

Memo

0.00

Small Fab

GRIND RAD PER DWG

SAD 10-02-05

10

120

0.00



QC5- Inspect part completeness to step on W/O

QC

Memo

0.00

Quality Control

⇒ S 10/02/08

10

W/O:		WORK ORDER CHANGES					
DATE	STEP	PROCEDURE CHANGE	By	Date	Qty	Approval Chief Eng / Prod Mgr	Approval QC Inspector

Part No: _____ PAR #: _____ Fault Category: _____ NCR: Yes No DQA: _____ Date: _____

Resolution: _____ Disposition: _____ QA: N/C Closed: _____ Date: _____

NCR:		WORK ORDER NON-CONFORMANCE (NCR)						
DATE	STEP	Description of NC Section A	Corrective Action Section B			Verification Section C	Approval Chief Eng	Approval QC Inspector
			Initial Chief Eng	Action Description Chief Eng	Sign & Date			

NOTE: Date & initial all entries

Work Order ID 55827

February 3, 2010 7:25:39 AM



Page 2

Item ID: D3443-7

Accept



Setup Start



Revision ID:

Stop



Item Name: Tubing

Start Date: 2/03/10 Start Qty: 6.00



Cust Item ID:

Required Date: 2/04/10 Req'd Qty: 6.00



Customer:

Reference:

Run Start



Stop



Approvals:

Process Plan:

Date:

Tooling:

Date:

QC:

Date:

SPC (Y/N):

Date:

Sequence ID/
Work Center ID

Operation
Description

Set Up/
Run Hours

Draw
Number

Draw
Rev.

Plan
Code

Accept
Qty

Reject
Qty

Reject
Number

Insp.
Stamp

130



Mill Conv

Conventional Milling Machine

CONVENTIONAL MILLING MACHINE

Memo

0.00

0.00

88 10/22/08

10

0

1- Mill end to length and drill hole as per dwg D3443-112-Deburr as per dwg D3443

140



QC

Quality Control

QC2- Inspect parts off machine FAI/FAIB

Memo

0.00

0.00

88 10/22/08

10

0

150



QC

Quality Control

QC8- Inspect parts - second check

Memo

0.00

0.00

88 10/22/08

10

W/O:		WORK ORDER CHANGES					
DATE	STEP	PROCEDURE CHANGE	By	Date	Qty	Approval Chief Eng / Prod Mgr	Approval QC Inspector

Part No: _____ PAR #: _____ Fault Category: _____ NCR: Yes No DQA: _____ Date: _____

Resolution: _____ Disposition: _____ QA: N/C Closed: _____ Date: _____

NCR:		WORK ORDER NON-CONFORMANCE (NCR)						
DATE	STEP	Description of NC Section A	Corrective Action Section B			Verification Section C	Approval Chief Eng	Approval QC Inspector
			Initial Chief Eng	Action Description Chief Eng	Sign & Date			

NOTE: Date & initial all entries

Work Order ID 55827

February 3, 2010 7:25:40 AM



Page 3

Item ID: D3443-7

Accept



Setup Start



Revision ID:

Stop



Item Name: Tubing

Start Date: 2/03/10 Start Qty: 6.00



Cust Item ID:

Required Date: 2/04/10 Req'd Qty: 6.00



Customer:

Reference:

Run Start



Approvals: Process Plan:

Date:

Tooling:

Date:

Stop



QC:

Date:

SPC (Y/N):

Date:

Sequence ID/
Work Center ID

Operation
Description

Set Up/
Run Hours

Draw
Number

Draw
Rev.

Plan
Code

Accept
Qty

Reject
Qty

Reject
Number

Insp.
Stamp

160



Packaging

Packaging

Identify as per dwg & Stock Location: WAZ4

0.00

Memo

0.00

(10x) *[Signature]* 10/02/09

170



QC

Quality Control

QC21- Final Inspection - Work Order Release

0.00

Memo

0.00

10/02/09 *[Signature]*
mc
10-2-9

W/O:		WORK ORDER CHANGES					
DATE	STEP	PROCEDURE CHANGE	By	Date	Qty	Approval Chief Eng / Prod Mgr	Approval QC Inspector

Part No: _____ PAR #: _____ Fault Category: _____ NCR: Yes No DQA: _____ Date: _____

Resolution: _____ Disposition: _____ QA: N/C Closed: _____ Date: _____

NCR:		WORK ORDER NON-CONFORMANCE (NCR)						
DATE	STEP	Description of NC Section A	Corrective Action Section B			Verification Section C	Approval Chief Eng	Approval QC Inspector
			Initial Chief Eng	Action Description Chief Eng	Sign & Date			

NOTE: Date & initial all entries

Picklist Print

February 3, 2010 7:25:38 AM

Page 1
1

Work Order ID: 55827

Parent Item: D3443-7

Parent Item Name: Tubing

Comments: A1105.11.14 New issue[IEC]

Start Date: 2/03/10

Required Date: 2/04/10

Start Qty: 6.00

Required Qty: 6.00

Component Item ID/ Item Name	Replacement Item ID	Mfg/ Purch	Bin Item	Primary Location	Last Location	Route Seq ID	Unit of Measure	Qty on Hand	Remaining Qty To Pick	Qty Issued	Date Issued	Status
M304TR0.750W.120		Purchased	No			100	f	11.6553	4.7368			



304 ss round tube .750 x .120w



SAD 10-02-09

Warehouse

Loc Qty

Loc Code

Location

Main Warehouse

MAT

11.6553

111096

9.6948

111097

1.9605

→ ~~11.6553~~ 7,9

W/O:		WORK ORDER CHANGES					
DATE	STEP	PROCEDURE CHANGE	By	Date	Qty	Approval Chief Eng / Prod Mgr	Approval QC Inspector




Part No: _____ PAR #: _____ Fault Category: _____ NCR: Yes No DQA: _____ Date: _____

Resolution: _____ Disposition: _____ QA: N/C Closed: _____ Date: _____

NCR:		WORK ORDER NON-CONFORMANCE (NCR)						
DATE	STEP	Description of NC Section A	Corrective Action Section B			Verification Section C	Approval Chief Eng	Approval QC Inspector
			Initial Chief Eng	Action Description Chief Eng	Sign & Date			

NOTE: Date & initial all entries

8 7 6 5 4 3 2 1

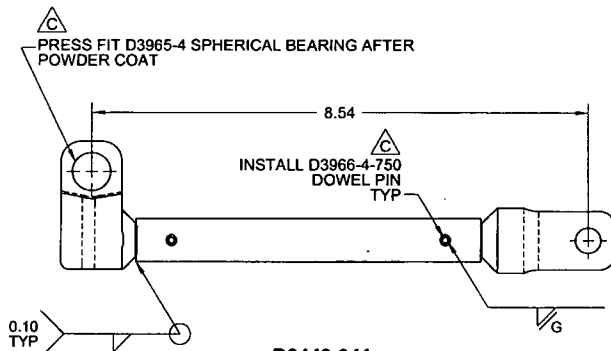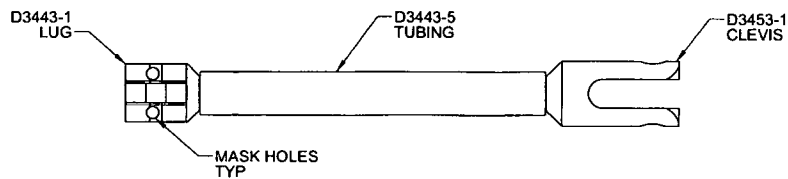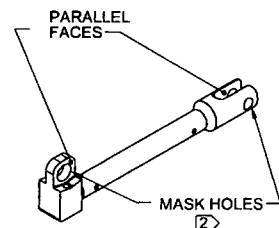

D3443-041

- NOTES:**
- 1) MATERIAL: N/A
 - 2) FINISH: POWDER COAT WHITE (4.3.5.2) PER DART QSI 005 4.3
NO POWDER COAT IN HOLES
 - 3) TOLERANCES: PER DART QSI 018 UNLESS OTHERWISE NOTED
 - 4) UNITS: INCHES UNLESS OTHERWISE NOTED
 - 5) BREAK SHARP EDGES: 0.005 TO 0.010 MAX
 - 6) IDENTIFICATION: IDENTIFY WITH DART P/N USING FINE POINT PERMANENT INK MARKER
 - 7) WEIGHT: 1.33 lbs
 - 8) WELD PER DART QSI 004

ITEM	QTY	P/N	DESCRIPTION
1	X	D3443-041	STRUT WELDMENT ASSEMBLY
2	1	D3443-1	LUG
3	1	D3443-5	TUBING
4	1	D3453-1	CLEVIS
5	1	D3965-4	BEARING, SPHERICAL
6	2	D3966-4-750	PIN, DOWEL

WLO 55827

RELEASED
09/08/25 M

C	DRAWING UPDATED TO CURRENT STANDARDS. REVISED NOTE #2 (ZN A8-1, A8-2); 0.820 WAS 0.720 & 1.43 WAS 1.53 (ZN C2-3); 0.551 WAS 0.451 (ZN C1-3); R0.219 WAS R0.050 (ZN C4-3); D3965-4 WAS SPAENAUER P/N (ZN C6-1, B5-2); D3966-4-750 WAS McMASTER-CARR P/N (ZN B5-1); REF PAR 09-018		RF	09.06.25
B	ADDED -9 PIN; REMOVED BALL PLUNGER; REVISE TOLERANCE; & Ø0.125 WAS #30		RF	05.12.05
A	NEW ISSUE		RF	05.09.02
REV.	DESCRIPTION		BY	DATE
DESIGN	RF	DART AEROSPACE LTD HAWKESBURY, ONTARIO, CANADA		
DRAWN	RF	DRAWING NO.	REV. C	
CHECKED	<i>[Signature]</i>	D3443	SHEET 1 OF 4	
MFG. APPR.	<i>[Signature]</i>	TITLE	SCALE	
APPROVED	<i>[Signature]</i>	STRUT WELDMENT ASSEMBLY NTS		
DE APPR.	<i>[Signature]</i>	COPYRIGHT © 2005 BY DART AEROSPACE LTD		
DATE	09.06.25	THIS DOCUMENT IS PRIVATE AND CONFIDENTIAL AND IS SUPPLIED ON THE EXPRESS CONDITION THAT IT IS NOT TO BE USED FOR ANY PURPOSE OR COPIED OR COMMUNICATED TO ANY OTHER PERSON WITHOUT WRITTEN PERMISSION FROM DART AEROSPACE LTD.		

8 7 6 5 4 3 2 1

W/O:		WORK ORDER CHANGES					
DATE	STEP	PROCEDURE CHANGE	By	Date	Qty	Approval Chief Eng / Prod Mgr	Approval QC Inspector




Part No: _____ PAR #: _____ Fault Category: _____ NCR: Yes No DQA: _____ Date: _____

Resolution: _____ Disposition: _____ QA: N/C Closed: _____ Date: _____

NCR:		WORK ORDER NON-CONFORMANCE (NCR)						
DATE	STEP	Description of NC Section A	Corrective Action Section B			Verification Section C	Approval Chief Eng	Approval QC Inspector
			Initial Chief Eng	Action Description Chief Eng	Sign & Date			

NOTE: Date & initial all entries

ITEM	QTY -043	P/N	DESCRIPTION
1	X	D3443-043	STRUT WELDMENT ASSEMBLY
2	1	D3443-3	CLEVIS
3	1	D3443-7	TUBING
4	1	D3966-4-750	PIN

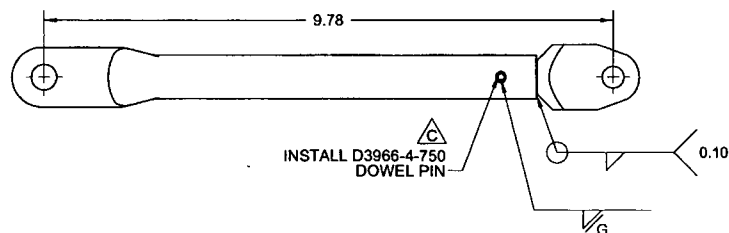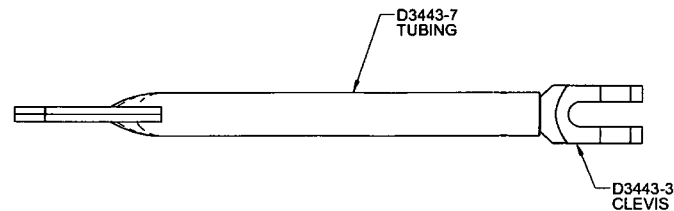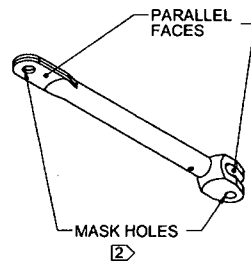

D3443-043

WLO
55827

RELEASED
09/06/25/14

NOTES:

- 1) MATERIAL: N/A
- 2) FINISH: POWDER COAT WHITE (4.3.5.2) PER DART QSI 005 4.3
NO POWDER COAT IN HOLES
- 3) TOLERANCES: PER DART QSI 018 UNLESS OTHERWISE NOTED
- 4) UNITS: INCHES UNLESS OTHERWISE NOTED
- 5) BREAK SHARP EDGES: 0.005 TO 0.010 MAX
- 6) IDENTIFICATION: IDENTIFY WITH DART P/N USING FINE POINT PERMANENT INK MARKER
- 7) WEIGHT: 0.97 lbs
- 8) WELD PER DART QSI 004

DESIGN	RF	DART AEROSPACE LTD	
DRAWN	RF	HAWKESBURY, ONTARIO, CANADA	
CHECKED	UP	DRAWING NO.	REV. C
MFG. APPR.		D3443	SHEET 2 OF 4
APPROVED		TITLE	SCALE
DE APPR.		STRUT WELDMENT ASSEMBLY	NTS
DATE	09.06.25	COPYRIGHT © 2005 BY DART AEROSPACE LTD THIS DOCUMENT IS PRIVATE AND CONFIDENTIAL AND IS SUPPLIED ON THE EXPRESS CONDITION THAT IT IS NOT TO BE USED FOR ANY PURPOSE OR COPIED OR COMMUNICATED TO ANY OTHER PERSON WITHOUT WRITTEN PERMISSION FROM DART AEROSPACE LTD.	




W/O:		WORK ORDER CHANGES					
DATE	STEP	PROCEDURE CHANGE	By	Date	Qty	Approval Chief Eng / Prod Mgr	Approval QC Inspector

Part No: _____ PAR #: _____ Fault Category: _____ NCR: Yes No DQA: _____ Date: _____





Resolution: _____ Disposition: _____ QA: N/C Closed: _____ Date: _____

NCR:		WORK ORDER NON-CONFORMANCE (NCR)						
DATE	STEP	Description of NC Section A	Corrective Action Section B			Verification Section C	Approval Chief Eng	Approval QC Inspector
			Initial Chief Eng	Action Description Chief Eng	Sign & Date			

NOTE: Date & initial all entries

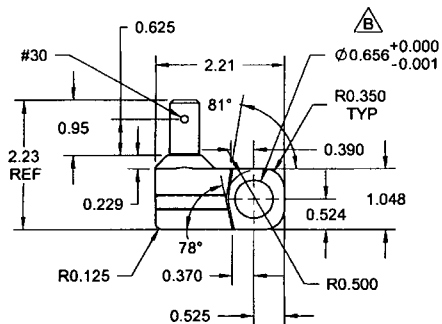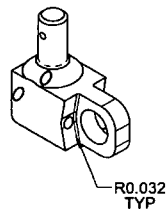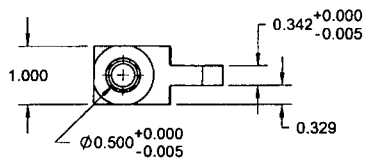

D3443-1 LUG

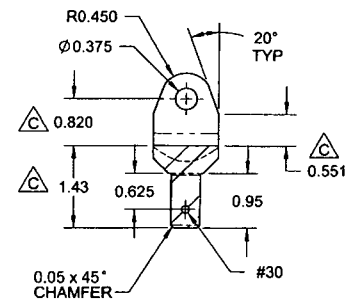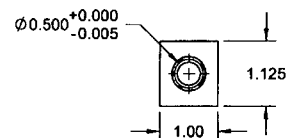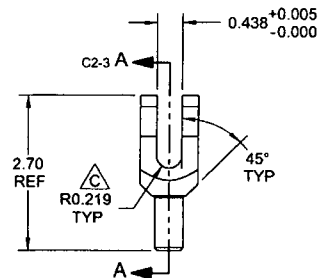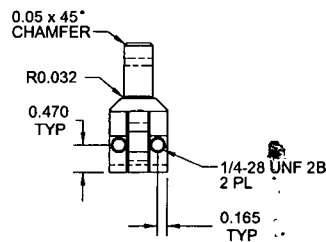




SECTION A-A C4-3


D3443-3 CLEVIS

RELEASED
07/25/14



 
NOTES:

- 1) MATERIAL: D3443-1 = 17-4 SS PER AMS 5604/5643 (REF DART SPEC M17-4B)
D3443-3 = AISI 304 SS ROUND BAR (REF. DART SPEC M304R)
- 2) FINISH: NONE
- 3) TOLERANCES: PER DART QSI 018 UNLESS OTHERWISE NOTED
- 4) UNITS: INCHES UNLESS OTHERWISE NOTED
- 5) BREAK SHARP EDGES: 0.005 TO 0.010 MAX
- 6) IDENTIFICATION: NONE
- 7) WEIGHT: D3443-1 = 0.50 lbs
D3443-3 = 0.35 lbs

DESIGN	RF	DART AEROSPACE LTD	
DRAWN	RF	HAWKESBURY, ONTARIO, CANADA	
CHECKED	UP	DRAWING NO.	REV. C
MFG. APPR.		D3443	SHEET 3 OF 4
APPROVED		TITLE	SCALE
DE APPR.		STRUT WELDMENT ASSEMBLY	NTS
DATE	09.06.25	COPYRIGHT © 2005 BY DART AEROSPACE LTD	
THIS DOCUMENT IS PRIVATE AND CONFIDENTIAL AND IS SUPPLIED ON THE EXPRESS CONDITION THAT IT IS NOT TO BE USED FOR ANY PURPOSE OR COPIED OR COMMUNICATED TO ANY OTHER PERSON WITHOUT WRITTEN PERMISSION FROM DART AEROSPACE LTD			

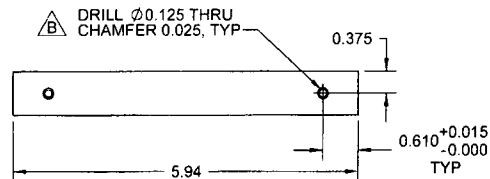




D3443-5 TUBING

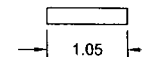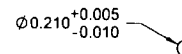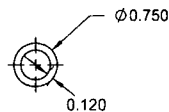

D3443-9 PIN

D3443-9 NOTES:

- 1) MATERIAL: DELRIN II 150R OR ACETRON GP ACETAL (REF. DART SPEC M-DELRIN-R)
- 2) FINISH: NONE
- 3) TOLERANCES: PER DART QSI 018 UNLESS OTHERWISE NOTED
- 4) UNITS: INCHES UNLESS OTHERWISE NOTED
- 5) BREAK SHARP EDGES: 0.005 TO 0.010 MAX
- 6) IDENTIFICATION: NONE
- 7) WEIGHT: N/A

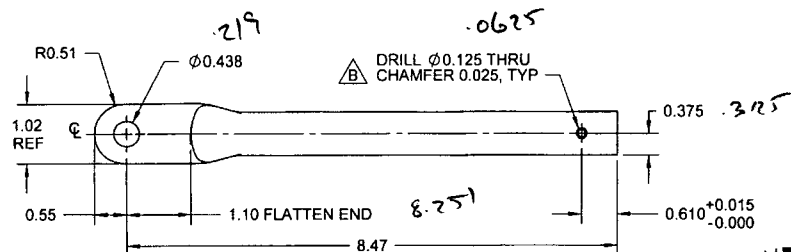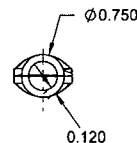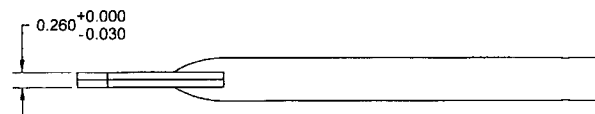

D3443-7 TUBING

D3443-5/-7 NOTES:

- 1) MATERIAL: AISI 316/304 SS SEAMLESS TUBING (REF. DART SPEC M304TR0.750W.120)
- 2) FINISH: NONE
- 3) TOLERANCES: PER DART QSI 018 UNLESS OTHERWISE NOTED
- 4) UNITS: INCHES UNLESS OTHERWISE NOTED
- 5) BREAK SHARP EDGES: 0.005 TO 0.025 MAX
- 6) IDENTIFICATION: NONE
- 7) WEIGHT: D3443-5 = 0.41 lbs
D3443-7 = 0.62 lbs

W55827

RELEASED
09/06/25 MD

DESIGN	RF	DART AEROSPACE LTD	
DRAWN	RF	HAWKESBURY, ONTARIO, CANADA	
CHECKED	<i>[Signature]</i>	DRAWING NO.	REV. C
MFG. APPR.	<i>[Signature]</i>	D3443	SHEET 4 OF 4
APPROVED	<i>[Signature]</i>	TITLE	SCALE
DE APPR.	<i>[Signature]</i>	STRUT WELDMENT ASSEMBLY NTS	
DATE	09.06.25	<small>COPYRIGHT © 2005 BY DART AEROSPACE LTD THIS DOCUMENT IS PRIVATE AND CONFIDENTIAL AND IS SUPPLIED ON THE EXPRESS CONDITION THAT IT IS NOT TO BE USED FOR ANY PURPOSE OR COPIED OR COMMUNICATED TO ANY OTHER PERSON WITHOUT WRITTEN PERMISSION FROM DART AEROSPACE LTD</small>	